


# Memo

То:	Board of Adjustment Chairperson McGinley and Secretary Kester Verona Board of Adjustment (BoA)
From:	Plan Review Committee of the Verona Environmental Commission
C:	Verona Environmental Commission Chair
Date:	February 25, 2025
Re:	<b>Case # 2025-01</b> 107 Hillside Avenue [Block 103, Lot 16] Verona, New Jersey
Zone:	R-50 (Residential High Density)

The Plan Review Committee of the Verona Environmental Commission (VEC) reviewed the application for 107 Hillside Avenue in Verona submitted by Chris and Lauren Hertz, which we received on January 14, 2025. We understand that the Applicant is seeking to obtain variances to construct a 2-story addition over an existing patio area and extend their patio, which exceeds total improved lot coverage and accessory structure coverage in the rear yard. The comments below are provided for the Board's consideration:

- Existing and Proposed Improved Lot Coverage is listed as 44% and 44.74% on the application, respectively. Scaling off the drawing, we calculated an Existing Improved Lot Coverage of 44.7% based on an Existing "Improved Area" of 2,903.1 ft<sup>2</sup> (please see attached annotated pdf). Furthermore, we calculated a Proposed Improved Lot Coverage of 45.8% based on a Proposed "Improved Area" of 2,973.0 ft<sup>2</sup> (an increase of about 70 ft<sup>2</sup>). We understand that the maximum Improved Lot Coverage for the R-50 Zone is 40%.
- 2) The VEC PRC understands that the Applicant proposed a net increase of impervious surface on the site of only 70 ft<sup>2</sup>, below the 400 ft<sup>2</sup> threshold. We also note that in addition to removing a portion of a gravel walkway with stepping-stones, that the Applicant is proposing to add a drywell to the eastern side of the property adjacent to the proposed addition. We recommend that downspouts are directed towards this drywell.
- 3) We recommend that any planned permanent plantings are in accordance with the <u>Recommended Plant Selection List</u> included in Verona's Zoning Code, §150.
- 4) We recommend that other downspout pipes on the home be disconnected from storm drains and redirected to flow away from the home, or neighboring homes, and over the property's permeable areas, gardens, and lawns.
- 5) In addition to the above comments, please see attached the Low Impact Planning and Construction Checklist. This suggested list was compiled by the VEC based on best available practices.

[JP/STD/WS] VEC\_2025-02-25 Comments 107 Hillside Ave.docx

 


ZONING	DATA	ZONE R-50	BLOCK 103	LOT 16
	ALLOWED	EXISTING	PROPOSED	
MINIMUM LOT SIZE	5,000 SF	6,476 SF	6,476 <del>SF</del>	ok.
MINIMUM LOT WIDTH	50'-0"	50'	50'	ok.
MINIMUM FRONT YARD	30'-0"	26.1' (EX. PORCH) 33.8' (EX. HOUSE)	26.1' (EX. PORCH) 33.8' (EX. HOUSE)	EXIST'G. NON- CONFORMING
MINIMUM SIDE YARD	8'-Ø"	6.6' RT. SIDE 9.3' LFT. SIDE	6.6' RT. SIDE 9.3' LFT. SIDE	EXIST'G. NON- CONFORMING ADDITION - OK PER - 150-133.B
MINIMUM SIDE YARD COMBINED	18'-0"	15.9'	-15.9' -	EXIST'G. NON- CONFORMING ADDITION - OK PER - 150-13.3.B
MINIMUM REAR YARD	30'-0"	61.6' ±	53.6' ±	OK.
MAXIMUM BLDG. HT.	30'-0" 2 1/2 STORY	32'-91/2"± 21/2 STORY	29'-6"± AT ADDITION 21/2 STORY	EXIST'G. NON-CONF. PROPOSED - OK
MAXIMUM BLDG. COV'G.	30 %	1296 S.F./ 6476= 20%	1581 S.F./ 6476= 24.41 %	OK.
MAXIMUM LOT COY'G.	40 %	2852 S.F./ 44 % 6476=	2897 SF./ 6476= 44.74 % 4.74% OVER REQ'D. 0.74% OVER EXST'G.	EXIST'G. NON-CONF. PROPOSED - VARIANCE REQ'D.
MAXIMUM FLOOR AREA RATIO	NA			
MAXIMUM AGGREGATE OF ACCESSORY STRUCTURES-	15% MAX. Existing- 3025x15% = 454 SF MAX	412 SF. PATIO 150 SF. SHED 562 SF. 108 SF. OVER 454 MAX.	324 SF. PATIO/STEPS 150 SF. SHED 474 SF. 84 SF. OVER 390 MAX.	EXIST'G. NON-CONF. PROPOSED - VARIANCE REQ'D.
REAR YARD	PROPOSED- 2600x15% = 330 SF MAX	562 3025= 18.6% (+3.6%)	474 2600= 183% (+33%)	


\* = INDICATES VARIANCE REQUIRED

# LIST OF DRAWINGS

ST-1 SITE PLAN, CODE INFO AND NOTES ST-2 SOIL EROSION SEDIMENT CONTROL PLAN, DETAILS AND NOTES FIRST FLOOR PLAN, SECOND FLOOR PLAN A-1 A-2 BASEMENT PLAN, ROOF PLAN A-3 EXTERIOR ELEVATIONS

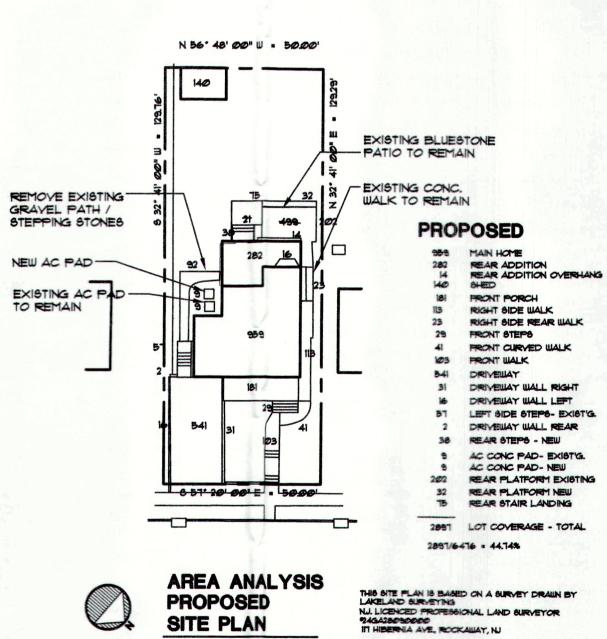

SCALE : 1" = 20'-0"

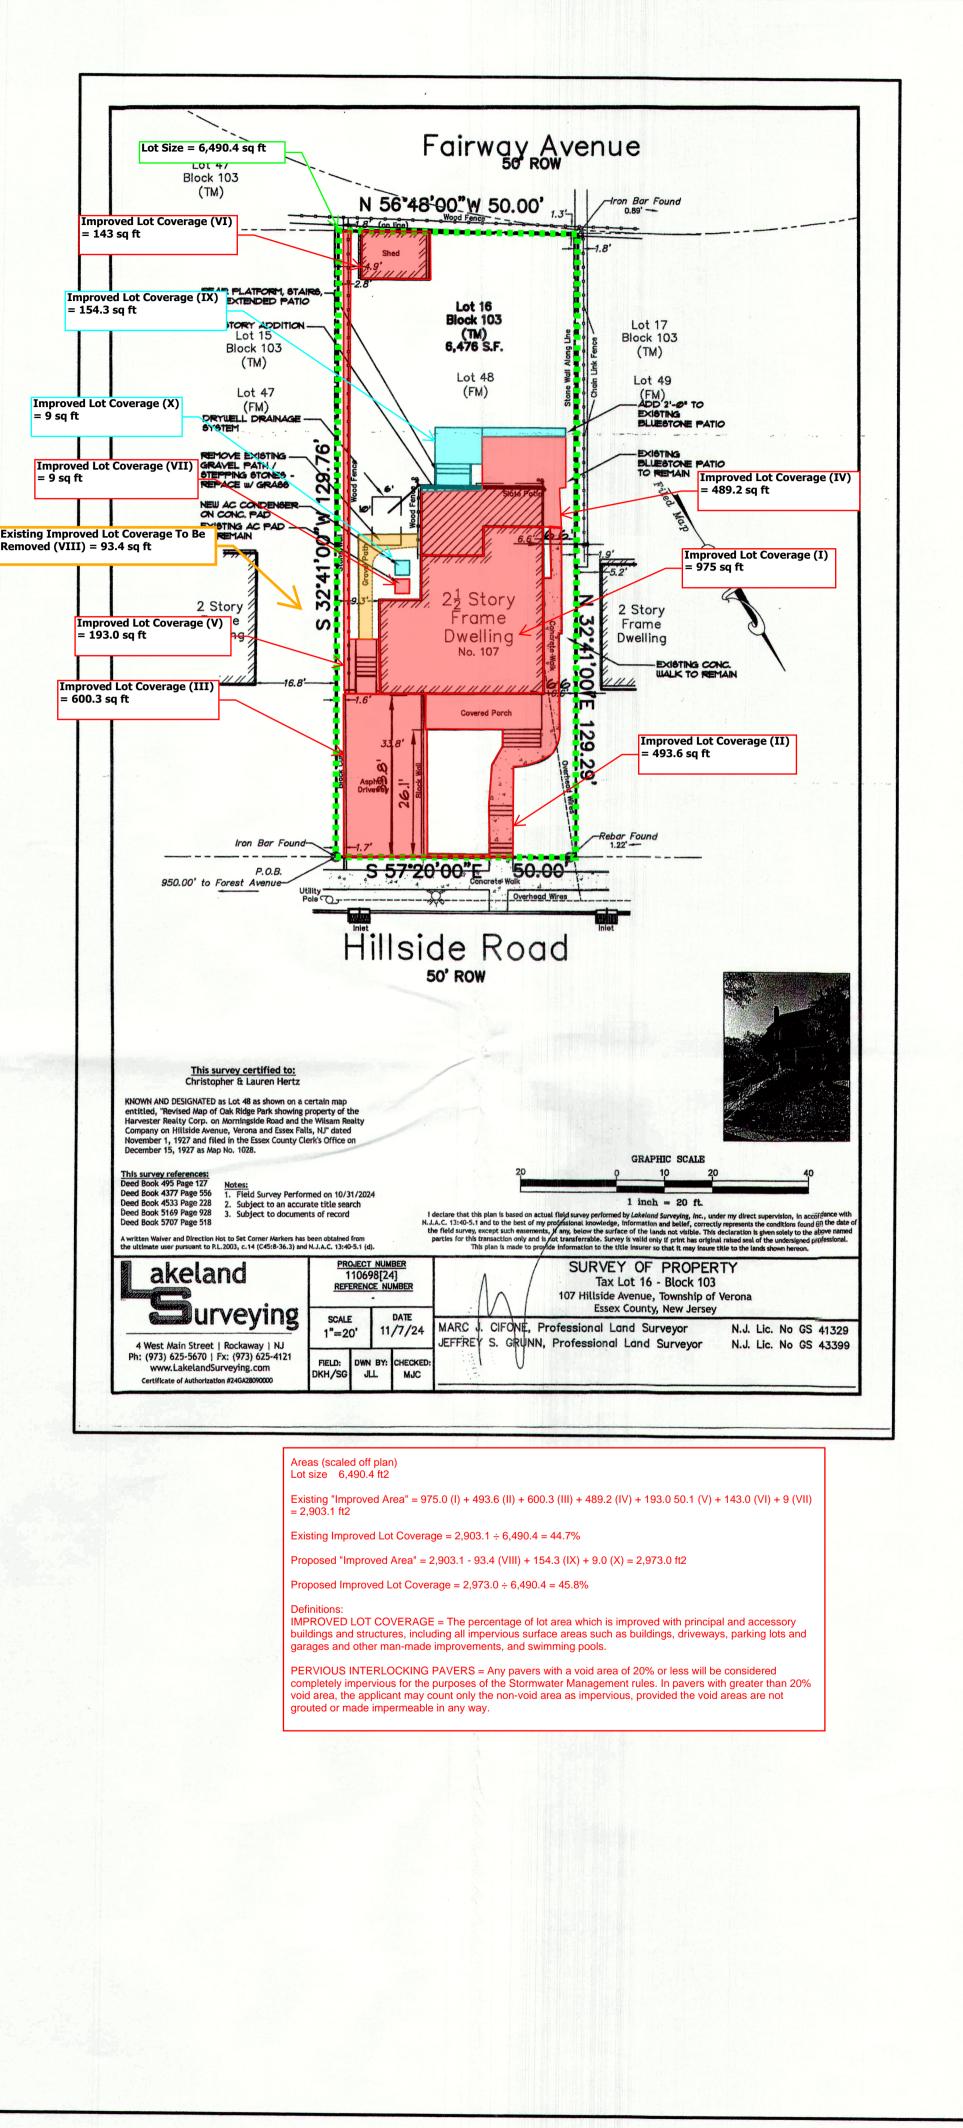

DRAUNG DATED 1-8-201

IRC COD	E NO	TES
2021 INTERNATION	E WITH THESE NAL BLD JERSEY NAL RESI JERSEY	e G. Code Edition
2.) USE GROUP CONSTR. CLA 3.) EXISTING SQU	488 5	
5.7 EXISTING SQL FIRST FLOOR SECOND FLO TOTAL -	- 000	959 SF. 698 SF.
SHED (NOT IN FRONT PORC		1657 S.F. 140 S.F. 181 S.F.
4.) New Square for		
FIRST FLOOR SECOND FLO TOTAL -		282 SF. 368 SF. 650 SF.
5.) TOTAL SQUAR FIRST FLOOR		4GE 1241 85.
SECOND FLO TOTAL -		
6.) TOTAL VOLUN NEW	1E	6159 CF.
ND DATE RE	VISIONS	
PROPOSED NEV	N ADDI	
CHRIS & L	AUR	EN
HERTZ		
107 HILLSIDE A		
VERONA, N.J. 0	/ 044	
SITE PLAN,	CODE	INFO,
AND NOTES DEMO PLAN	AND	NOTES
JSK ARCH	ITE	TUPE
LLC Jome		mas
JAMES S. KARA	S, ARCI	HITECT
27 BRIAR HILLS CIRC SPRINGFIELD, N.J. 07 TEL 973 - 487 - 93	7081	ECTE A
TEL. 973 - 467 - 93 FAX 973 - 218 - 844		IAMES 8. KARAS N.J. C-09597
DATE	JOB NO	
JAN. 10, 2025 SCALE	DWN. B	<b>0426</b> Y
AS NOTED	J.K.	
CHECKED	1	@≢ 5

# Verona Environmental Commission Low Impact Checklist: Construction

This suggested list has been compiled by the Verona Environmental Commission based on best available practices. This is not a requirement of the uniform construction code. It is intended to be beneficial to all residents considering renovations and new construction. The purposes of this list are to 1) assist those planning construction projects to do so in a manner that causes the least disruption to the environment; 2) establish a healthy setting for those occupying the new or renovated space; and 3) reduce waste and save resources. Implementing environmentally friendly practices can be economical when considered at pre-construction stages and are often beneficial in the long term.

#### **General Construction**

Recycle and/or salvage non-hazardous construction and demolition debris

Use renewable building material and products

□ Incorporate renewable energy (i.e. geothermal, solar)

Use local products (i.e. local and sustainable woods)

Use local construction products and companies

Conserve energy and reduce electricity use as much as possible

## **Grounds & Landscaping**

Create a sedimentation control plan to prevent sediment from moving off site.

Use native plantings (Native plans are adapted to thrive in local conditions)

 $\Box$  Use captured rainwater or recycled grey water for irrigation

Provide bicycle parking to help reduce overcrowded streets and CO2 emissions.

#### **Storm Water Management**

Avoid runoff to other properties by installing an underground cistern or rain garden.

This will keep water on your own property and out of the sewer system.

Limit impervious surfaces – use an open grid pavement system (at least 50% pervious)

Promote infiltration that captures and treats storm water runoff from rainfall

Use a water retention system (i.e. rain barrel) to collect rainwater for non-potable uses

## Lighting

Choose LED lights (the most environmentally-efficient option)

Purchase renewable electricity, either directly from your power supplier, from an independent clean power generator, or through renewable energy certificates.

Use skylights or solo tubes for natural daytime lighting. Use sensor controls in commercial or industrial settings and solar lighting outdoors.

#### Foundation & Basement

Use environmentally friendly foundation sealants (rather than black tar)

Prevent sump pump water from flowing into the sewer system

#### Roofing

Use light color roofing materials to limit heat absorption created by darker roofs

Use roofing material with a solar reflectance index (SRI) equal to or greater than 78 for low roofs and 29 for steep-sloped roofs

□ Install tile or metal roofs

Consider installing a vegetated roof

# Heating & Cooling

 $\Box$  Use 2 x 6 studs instead of 2 x 4 to increase amount of insulation

□ Install programmable thermostats that adjust temperatures throughout the day

Use occupant sensing and/or remote control thermostat technologies

□ Install heat pumps to transfer energy heat and cold Use high-efficiency boilers/furnaces

Use attic fans to regulate heating and cooling

## Windows

Choose ultraviolet window protection to protect against sun damage

□ Install triple pane windows or windows with Argon or Kryton gas between panes

## Products

Choose products with low VOCs (VOCs are found in adhesives, interior paints, cabinets, etc)

Avoid products that contain hazardous chemicals such as formaldehyde and cyanide

□ Choose ENERGY STAR<sup>®</sup> appliances

☐ Install dual flush toilets Install low flow shower heads

Avoid garbage disposals and make provisions for composting

# Verona Environmental Commission Low Impact Checklist: Planning

This suggested list has been compiled by the Verona Environmental Commission based on best available practices. This list is intended to assist individuals involved in planning and building projects in Verona Township towards submitting low impact plans. The goal of a low impact plan is not only to increase cost savings and add value to your project but to make environmentally responsible choices and eliminate project delays in early stages of the planning process.

## **General Construction & Design**

Provide occupants with connection to outdoor space through increased natural light and views

Orient buildings facing southwest to maximize potential solar installation

Use orientation and design to maximize passive solar heat/cooling

- Use proper planning to prevent damage to surrounding properties and public spaces
- ☐ Minimize disturbance to soils and vegetation
- Recycle and/or salvage non-hazardous construction and demolition debris
- Use renewable building materials and products
- Use local and sustainable woods
- ☐ Incorporate renewable energy and reduce energy use

## **Grounds & Landscaping**

Create a sedimentation control plan Limit altering steep slope areas

Encourage landscaping that requires limited moving, trimming, and watering

 $\Box$  Create landscapes that limit the need for lawn chemicals and maintenance

 $\Box$  Position evergreens to the north to shield wind/ Position deciduous trees to the south to cool buildings

- Use native plantings (Native plans are adapted to thrive in local conditions)
- □ Place parking spaces in shaded areas
- □ Place bicycle parking racks in secure areas near entrances

 $\Box$  Use paving materials with an SRI value >29. This will reflect, not absorb solar heat.

# **Storm Water Management**

□ Limit impervious surfaces – use an open grid pavement system (at least 50% pervious)

 $\Box$  Reduce impervious cover to promote infiltration that captures and treats storm water

Use a water retention system (i.e. rain barrel) to collect rainwater or recycled gray water for non-potable uses

#### Foundation & Basement

Use alternative practices (rather than black tar) for foundation sealants

Encourage aeration and ventilation

Draw sunlight into basement areas through access windows

### Roofing

Use light color roofing materials to limit heat absorbed by dark colored roofs

Use roofing material with a solar reflectance index (SRI) equal to or greater than 78 for

low roofs and 29 for steep sloped roofs

- Consider Tile or Metal roofs
- $\Box$  Construct roofs that can support solar installations

## Lighting

Use solar lighting outdoors

Use skylights or solo tubes for natural daytime lighting

Use motion sensor lighting where applicable

Choose energy-efficient light bulbs

## Products

Avoid products that contain hazardous chemicals such as formaldehyde and cyanide

Use local products (i.e. local and sustainable woods)

Use local construction equipment and companies when possible

For more information and resources please see:

The Native Plant Society of New Jersey - <u>http://www.npsnj.org</u> The Association of New Jersey Environmental Commissions - <u>http://www.anjec.org</u> US Green Building Council NJ Chapter - <u>http://usgbc.org</u> New Jersey Green Building Manual - <u>http://greenmanual.rutgers.edu</u> The New Jersey Department of Transportation Master Plan - <u>http://njbikepedplan.com</u> Rutgers Center for Green Building - <u>http://greenbuilding.rutgers.edu</u> The Verona Environmental Commission - <u>http://www.veronaec.org</u>